

SOIL EROSION AND SEDIMENTATION CONTROL MEASURES


MICHIGAN UNIFIED KEYING SYSTEM

- 2 SELECTIVE GRADING AND SHAPING
- 6 SEED WITH MULCH AND MATTING
- 7 HYDROSEEDING
- 12 COMPACTION
- 13 RIP RAP, RUBBLE, GABBIONS
- 14 AGGREGATE COVER
- 15 PAVING
- 16 CURB AND GUTTER
- 21 FILTER BERM
- 38 STRAW BALE FILTER
- 40 INLET SEDIMENT TRAP
- 41 STONE AND ROCK CROSSING
- 42 TEMPORARY CULVERT
- 45 TEMPORARY STREAM CHANNEL CHANGE
- 48 CONSTRUCTION DAM

THE ABOVE CONTROL MEASURES WILL BE USED DURING THE CONSTRUCTION OF THIS PROJECT AND RESTORATION TO EXISTING CONDITIONS WILL BE IN ACCORDANCE WITH THE CONTRACT DOCUMENTS.

STANDARD SYMBOLS

- RIGHT-OF-WAY LINE
- PROPERTY LINE
- CENTER LINE, BASE LINE OR SECTION LINE (LABEL)
- QUARTER LINE
- EIGHTH LINE
- CORPORATE LIMITS OR VILLAGE LIMITS
- EXISTING WATERMAIN
- PROPOSED WATERMAIN
- EXISTING VALVE
- EXISTING METER BOX AND/OR SHUT-OFF VALVE
- PROPOSED VALVE
- EXISTING HYDRANT WITH SHUT-OFF VALVE
- EXISTING HYDRANT WITHOUT SHUT-OFF VALVE
- PROPOSED HYDRANT WITH SHUT-OFF VALVE
- L.B.
- EXISTING STORM SEWER LINE
- PROPOSED STORM SEWER LINE
- EXISTING CATCH BASIN
- PROPOSED CATCH BASIN
- EXISTING STORM MANHOLE
- PROPOSED STORM MANHOLE
- EXISTING SANITARY SEWER LINE
- PROPOSED SANITARY SEWER LINE
- EXISTING SANITARY MANHOLE
- PROPOSED SANITARY MANHOLE
- EXIST LIFT STATION
- LIFT STATION No. 1
- GAS LINE MARKER (G.L.M.)
- GAS LINE
- GAS SHUT-OFF VALVE
- TELEPHONE LINE
- TELEPHONE POLE
- T.P.
- ELECTRIC LINE
- P.P.
- GUY WIRE
- G.P.
- GUY WIRE
- SERVICE LINE (GAS, ELECTRIC & TELEPHONE)
- LIGHT POLE
- SIREN (ALARM)
- T.B. #1
- SOIL BORING
- SECTION CORNER
- MON.
- MONUMENT CORNER
- PROPERTY CORNER
- FENCE
- GUARD RAILING & POST
- EXISTING TREES (TYPE & SIZE)
- HEDGES
- BUSHES
- INFORMATION SIGN (SPEED, PARKING, STOP, ETC.)
- RAILROAD CROSSING SIGNAL
- MAIL BOX

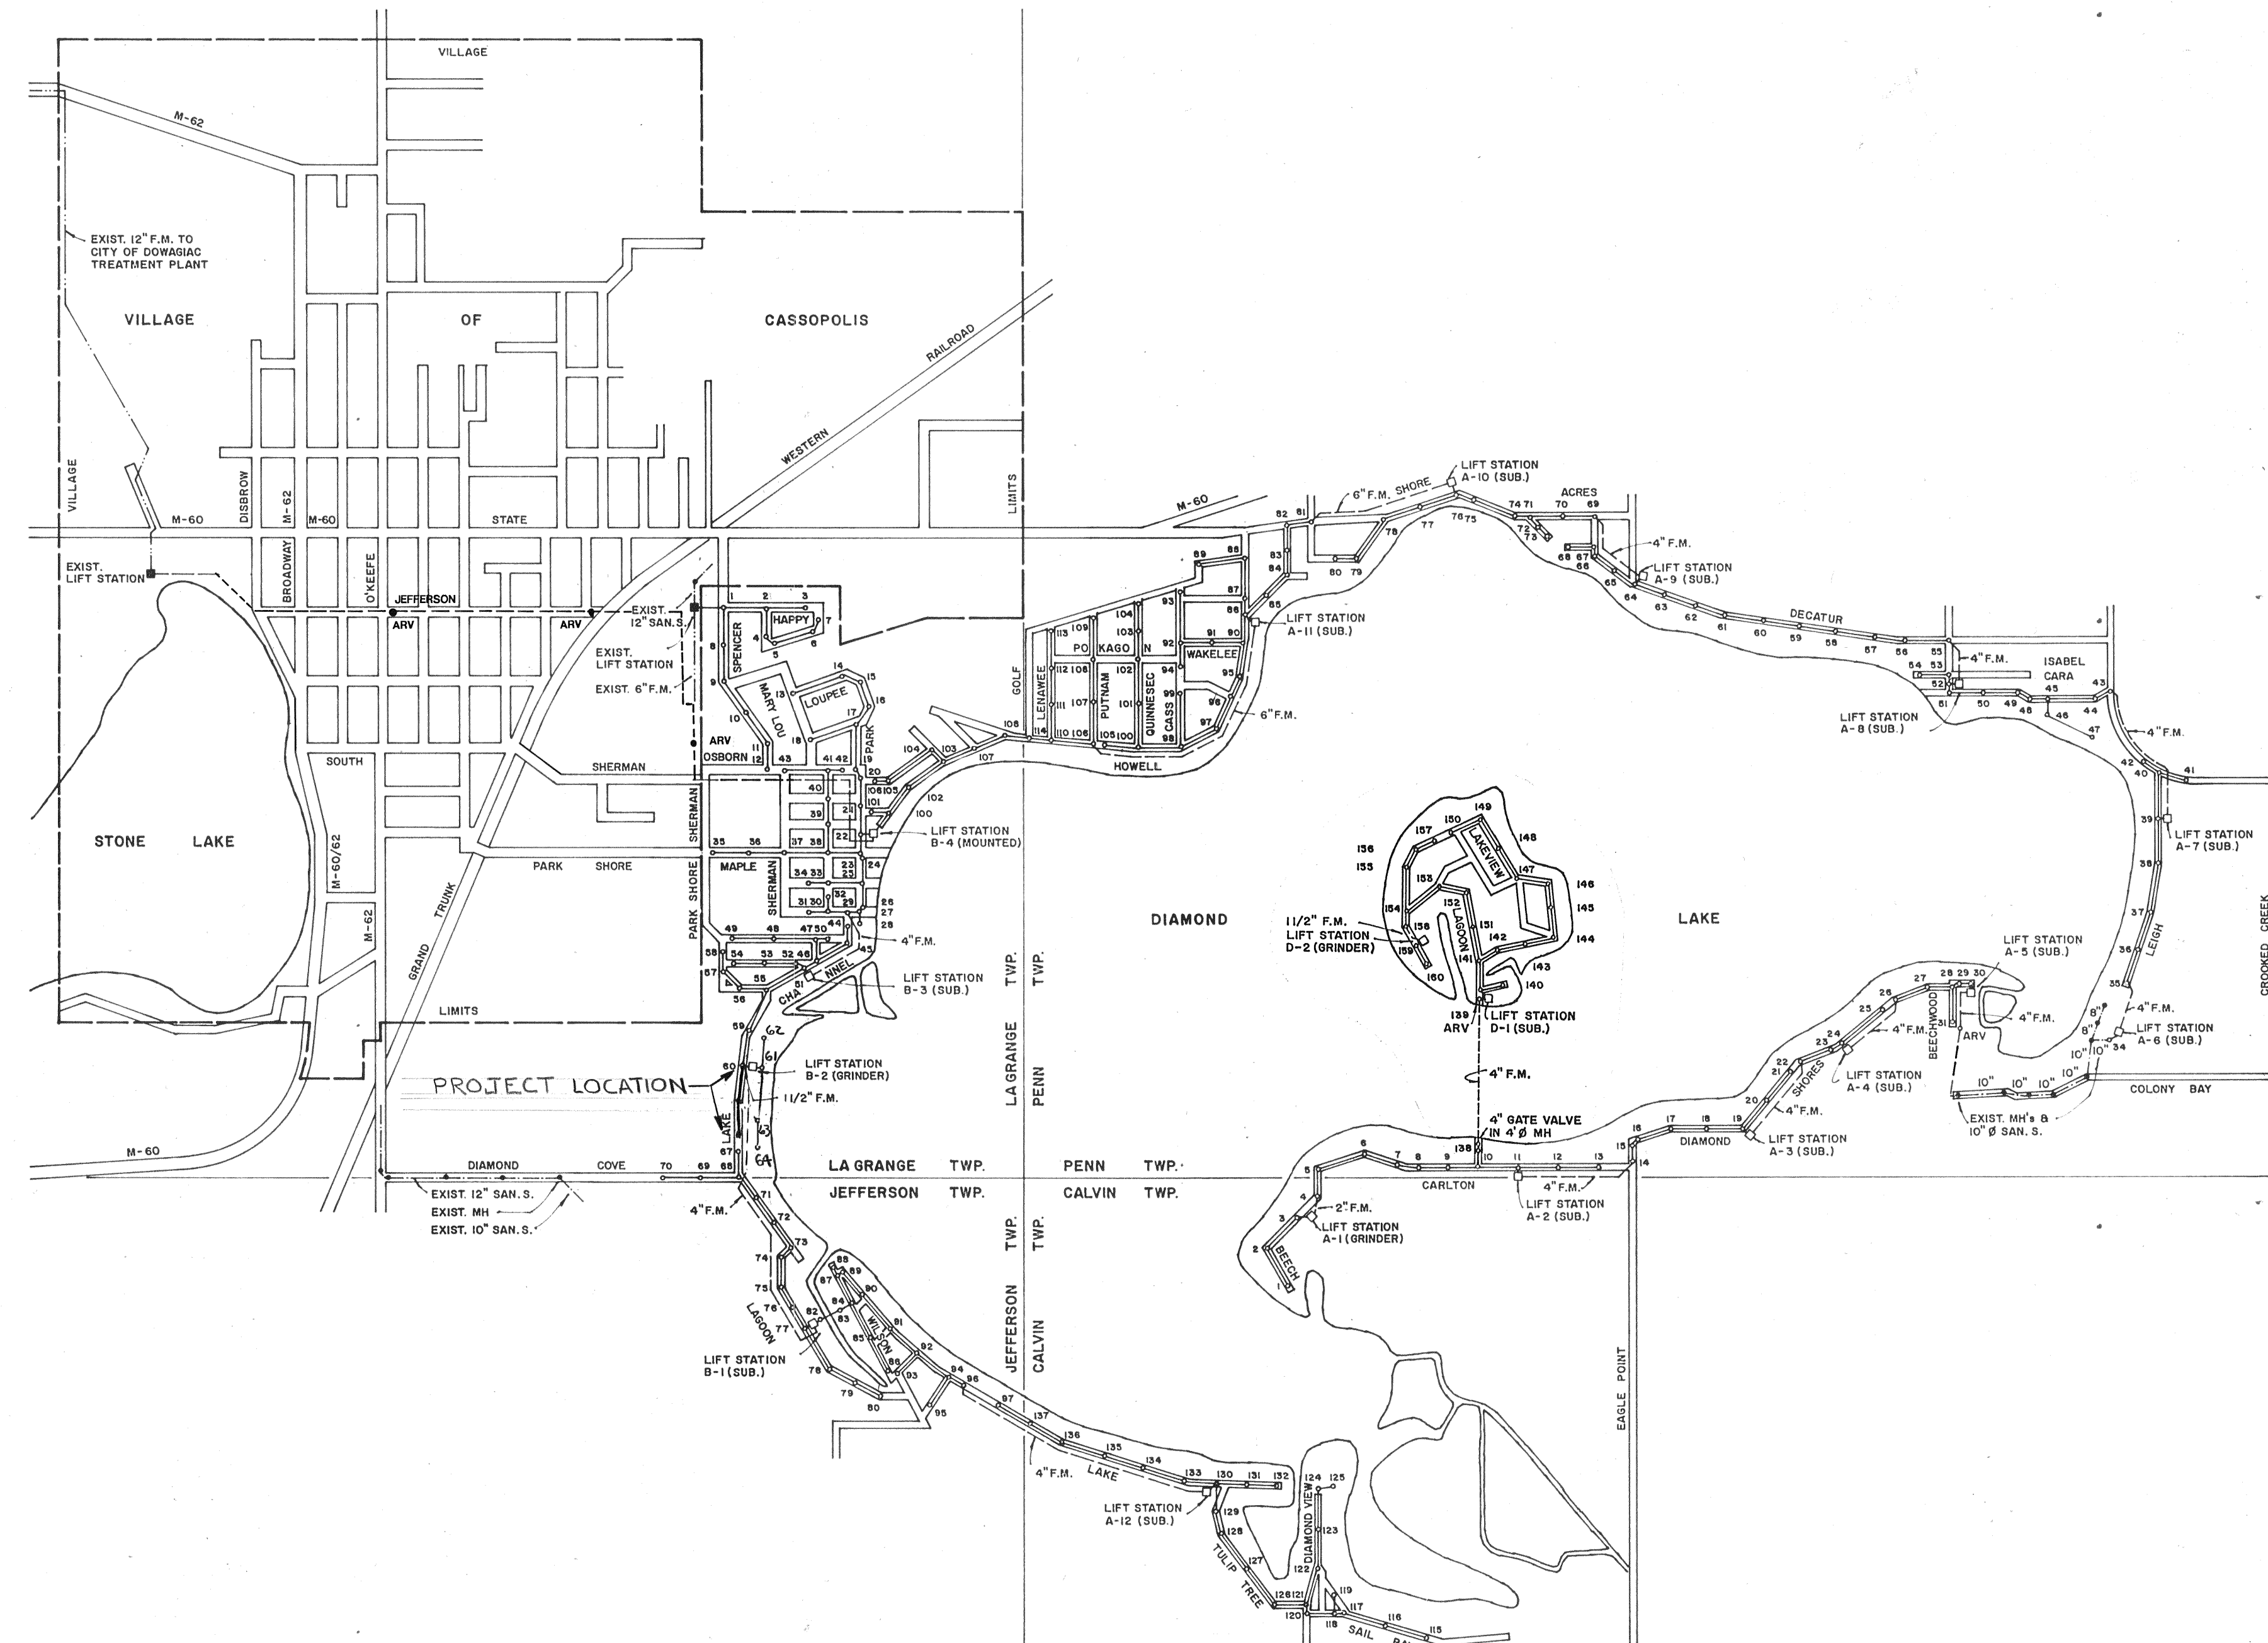

NOTES

UTILITY PROTECTION - CALL "MISS DIG" 48 HOURS PRIOR TO EXCAVATION, TOLL FREE 1-800-482-7171
 RIGHT-OF-WAY LINES ARE APPROXIMATE, NOT ESTABLISHED BY SURVEY.

CONTRACTOR UNDER CONTRACT "C" SHALL EXTEND THE GRAVITY SEWER AND FORCE MAIN TO A POINT 5'-0" BEYOND THE LIFT STATION LIMITS. CONTRACTOR UNDER CONTRACT "A" AND/OR "B" SHALL CONNECT TO THESE PIPES AS REQUIRED.

"AS BUILT"
 CONTRACT "C"
 LIFT STATIONS & EQUIPMENT

CASSOPOLIS AREA UTILITIES AUTHORITY "DIAMOND LAKE" WASTEWATER COLLECTION SYSTEM		
SCALE: 1" = 1000'	APPROVED BY: TAD	DRAWN BY: PS
DATE: MAY, 1987		REVISED:
WIGHTMAN & ASSOCIATES, INC. 920 BROAD STREET ST. JOSEPH, MICHIGAN		
GENERAL LOCATION MAP		DRAWING NUMBER 2 OF 10